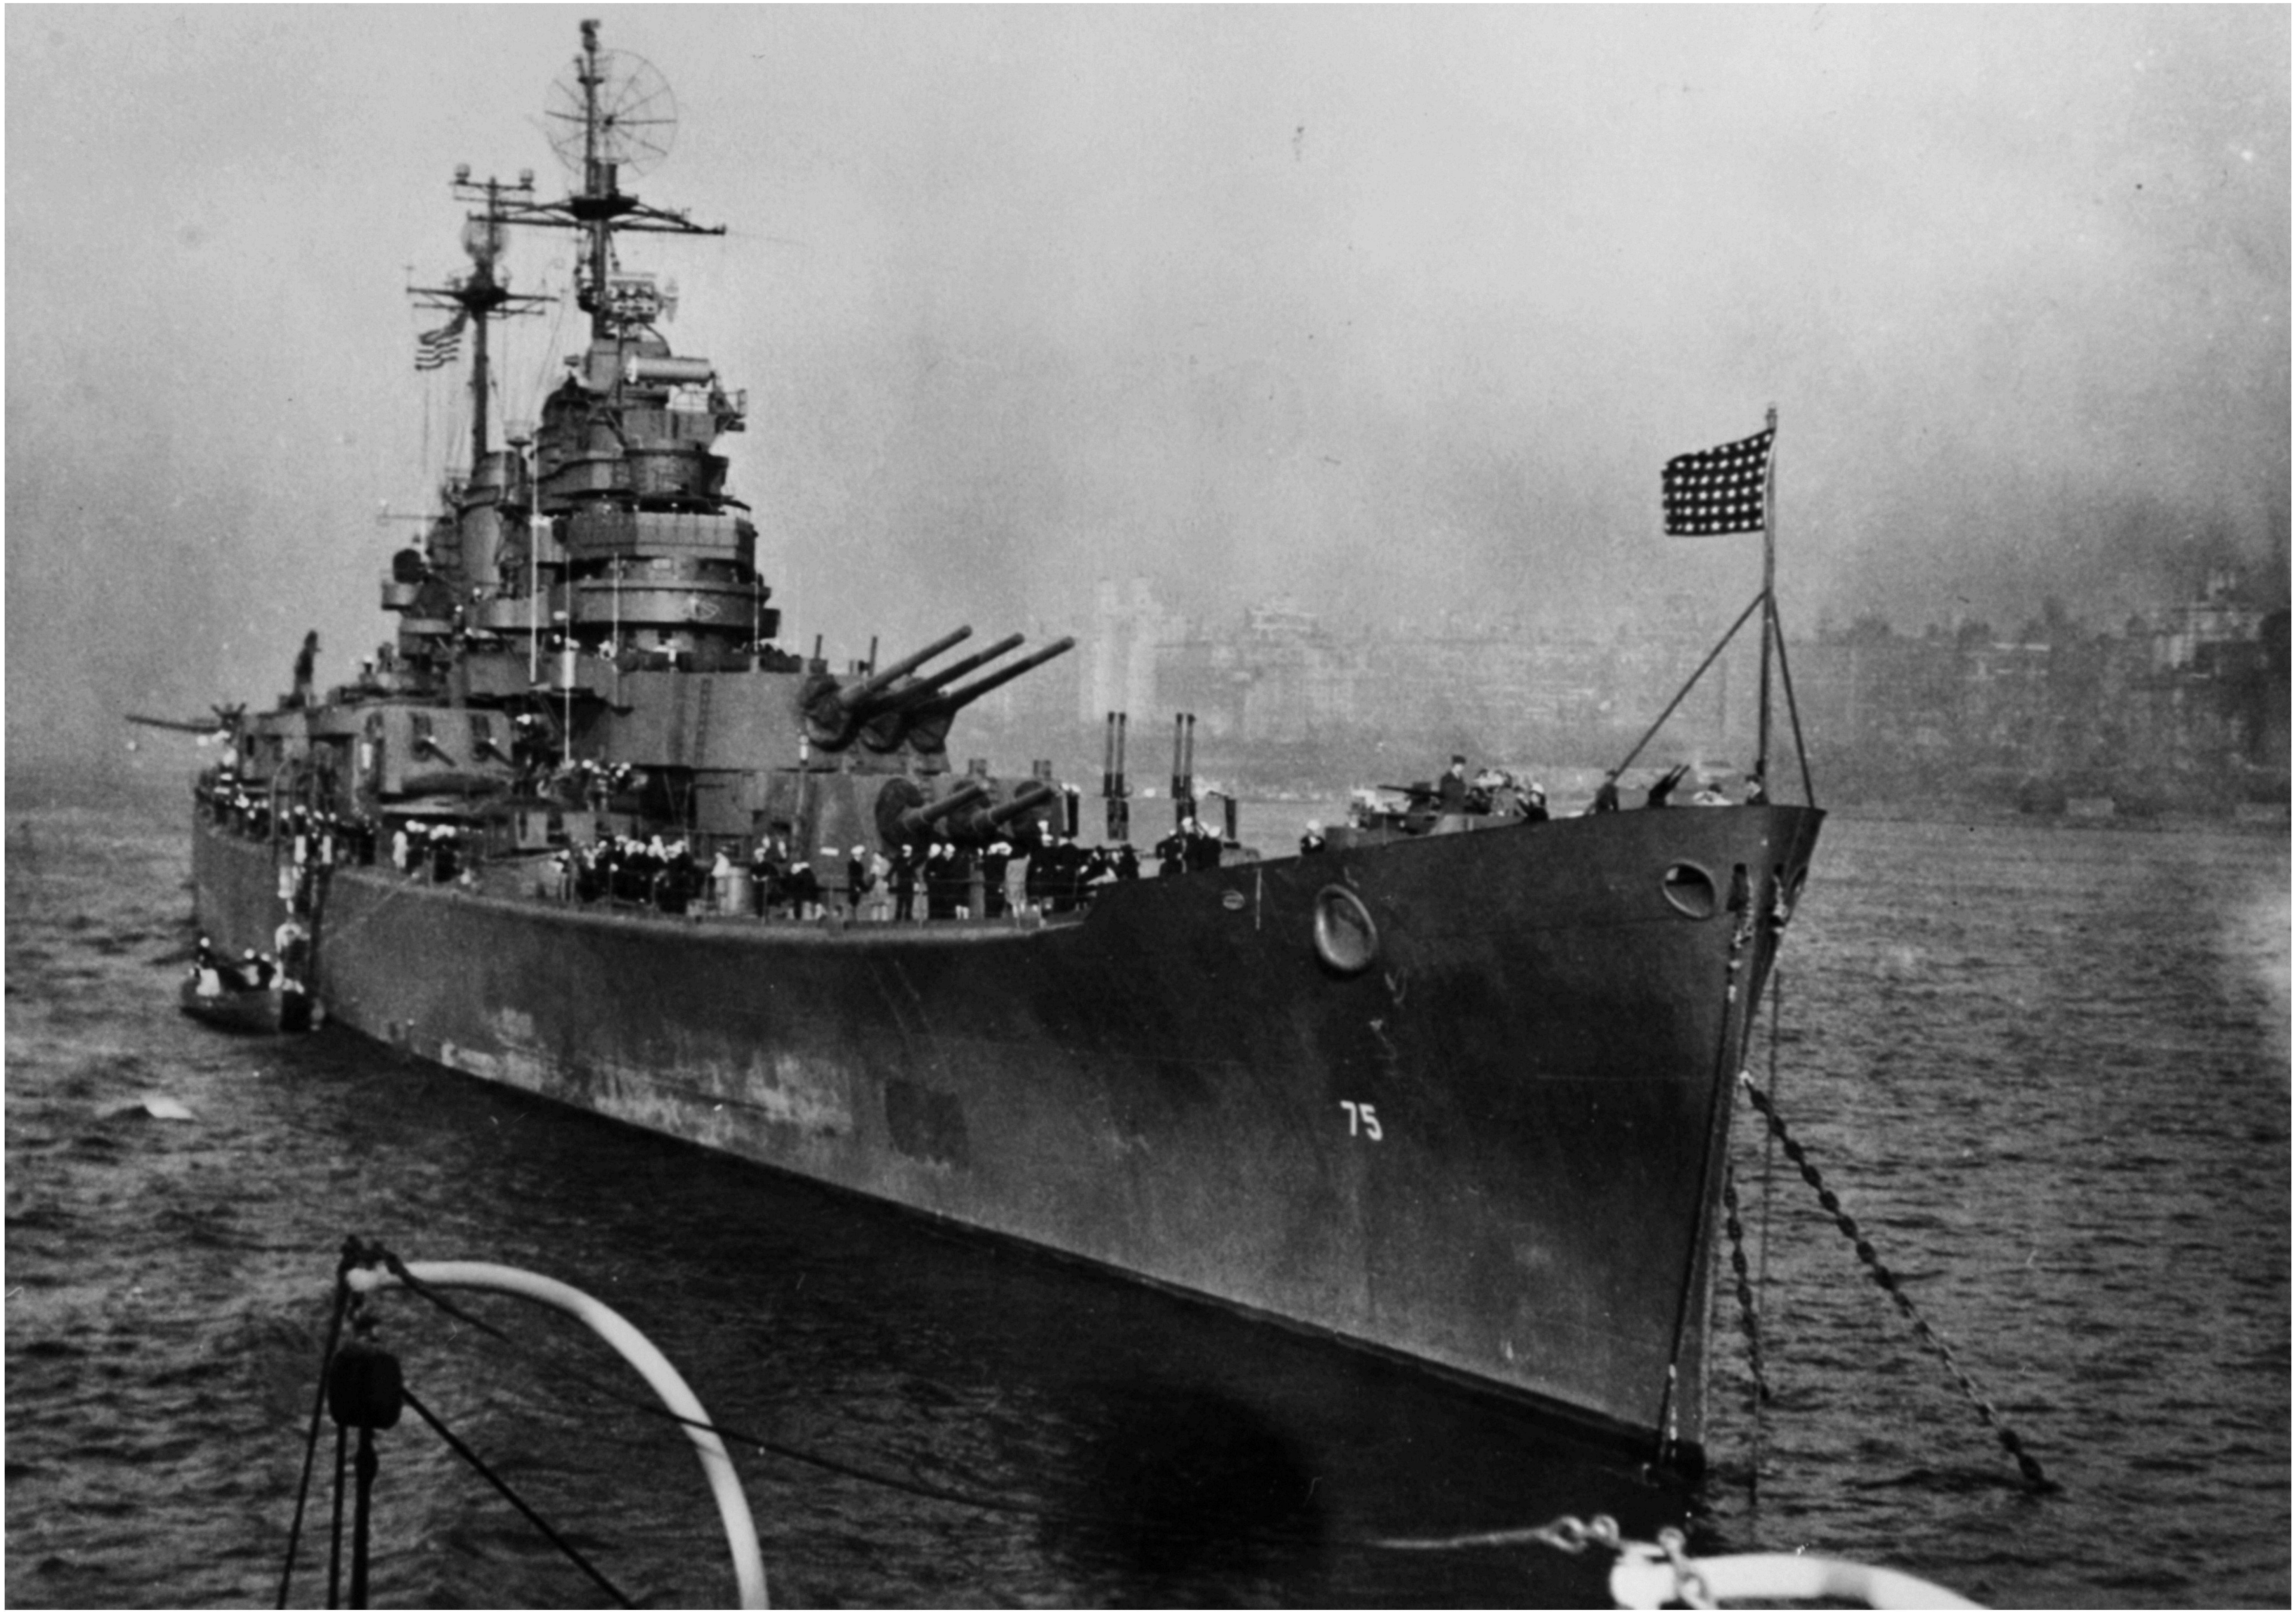
75

CA73 thru CA75 Incl.

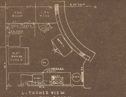

℄ OF SHIP
FAN ROOM
C.P.O. MESS
RACK
RACK
D.W. MACH. CONTROL
REFRIG.
ELEC. RANGE TYPE A
I.C. PRESSER UNDER
SINK
RACK
M.H.

DETACHED VIEW.
C.P.O. PANTRY C-202-3L.
FOR CA 74 AND 75.

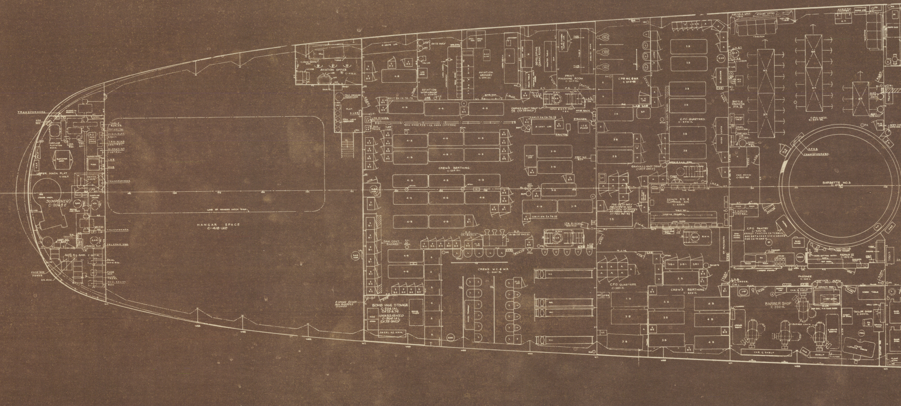

TRANSFORMERS
AIRPLANE ELEVATOR MACH.
ELEVATOR CONT.
UPPER MACH. FLAT C-206 E
SUMP (OVER) C-206 E
CRANE MACH.
GASOLINE TRUNK
TRAINING CONTROL
ELEVATING CONTROL
TRANSFORMERS
TELCOMM. SBB.
40 MM. AMM. C-207 M.
FUSE BOX POWER
HANGAR SPACE C-418-1AE
LINE OF HANGAR HATCH OVER
AVIATION OFFICE C-418 1L
AVIATION WORKSHOP C-204 1AL
AVIATION ARMORY C-204 1AL
DEVELOPING (DARK) ROOM
PRINT FINISHING ROOM C-204 2L
CREW'S BERTHING C-204 1AL
CANVAS LIGHT TRAP (CA 75 ONLY)
I.C.E. PUMP
STRAINER
FIRST AID BOX
CREWS W.C. & W.R. C-244-3L
DAM. CONT. SHORES
BOMB VANE STOWAGE C-204 1AL CA73 & 74
UNASSIGNED C-204 1AL CA75 ONLY
2-SPARE 40 MM GUN BARRELS STOWED
C.P.O. W.C. & W.R. C-203-8L
C.P.O. QUARTERS C-203-1L
C.P.O. QUARTERS C-203-1L
20 MM R.S. & CLIPPING RM. C-203H
CREW'S BERTHING C-203-1L
BATTLE DRESSING STA. II
FAN ROOM C-202-4E
C.P.O. MESS C-202-1L
C.P.O. PANTRY C-202-3L
BARBETTE NO. 3
TRANSFORMERS
REPAIR III C-202-1L
PASSAGE C-202 L
BARBER SHOP C-202-1L
TAILOR SHOP C-202-1L
BARBER CHAIR
CAB. & SHELF
TRANSOM
STOWED LITTER

CA73 thru CA75 Incl.

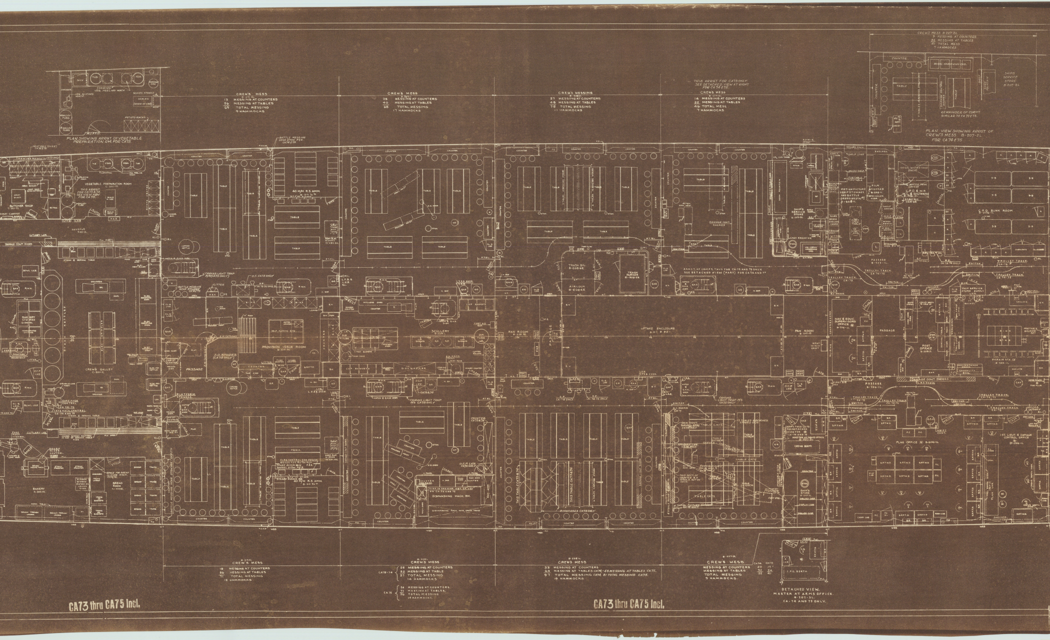
PLAN SHOWING ARRGT. OF VEGETABLE PREPARATION RM. FOR CA75.
SINK
TUB
TUB
COAMING
VEG. PEELING MACH.
GARBAGE CAN
SCALES STOWED
SCALES (WHEN IN USE)
VEG. SLICING MACH.
GALLEY TUBS
4 GALLEY TUBS
POTATO RACKS
CREW'S MESS
13 MESSING AT COUNTERS
56 MESSING AT TABLES
69 TOTAL MESSING
9 HAMMOCKS
CREW'S MESS
28 MESSING AT COUNTERS
40 MESSING AT TABLES
68 TOTAL MESSING
17 HAMMOCKS
CREW'S MESSING
27 MESSING AT COUNTERS
48 MESSING AT TABLES
75 TOTAL MESSING
HAMMOCKS
THIS ARRGT. FOR CA73 ONLY SEE DETACHED VIEW AT RIGHT FOR CA74 & 75.
CREWS MESS
14 MESSING AT COUNTERS
32 MESSING AT TABLES
46 TOTAL MESS
7 HAMMOCKS
CREWS MESS B-207-2L
9 MESSING AT COUNTERS
32 MESSING AT TABLES
41 TOTAL MESS
7 HAMMOCKS
COUNTER
80 GAL HARDENING CAB.
SHIPS SERVICE STORE B-207-2L
TABLE
7 TABLES & BENCHES STOWED
DAMAGE CONTROL SHORES
SHELF
SODA FOUNTAIN
REMAINDER OF COMPT. SIMILAR TO CA 72 & 73.
40 MM AMM. HOIST
PLAN VIEW SHOWING ARRGT OF CREW'S MESS B-207-2L FOR CA 74 & 75
MEAT RAIL (OVER) CA73 & 75
THAWING BASKETS CA73 ONLY
BATTLE MESSING GEAR STOW. P&S CA74 & 75
VEGETABLE PREPARATION ROOM
THIS ARRGT. FOR CA73 & 74
BUTCHER SHOP
COUNTER
TABLE
40 MM R.S. AMM.
CREWS GALLEY
BAKERY
BREAD ROOM
PROVISION ISSUE ROOM
S.D. STORES (CA75 ONLY)
PASSAGE
SCULLERY
DISHWASHING MACH. RM.
FAN ROOM
UPTAKE ENCLOSURE
TRASH BURNER
AIRLOCK
SHIP'S SERVICE STORE
DAMAGE CONT. SHORES
C.P.O. BUNK ROOM
RECORD RACK
SHELVES
100 GAL WATER TANK (OVER)
POST OFFICE
NAV. & EDUC. SUPERVISORS OFFICE
PASSAGE
TROLLEY TRACK
REPAIR STA.
FLAG OFFICE
1ST LIEUT. & DAMAGE CONTROL OFFICE
CANVAS LIGHT TRAP P/S CA73 ONLY
BOOKCASES CA73 ONLY
TABLE CA73
W.T.
W.S.B.
CREW'S MESS
18 MESSING AT COUNTERS
56 MESSING AT TABLES
71 TOTAL MESSING
15 HAMMOCKS
CREW'S MESS
CA73-74 25 MESSING AT COUNTERS
32 MESSING AT TABLE
57 TOTAL MESSING
14 HAMMOCKS
CA75 24 MESSING AT COUNTERS.
32 MESSING AT TABLES.
56 TOTAL MESSING
14 HAMMOCKS.
CREW'S MESS
33 MESSING AT COUNTERS
64 MESSING AT TABLES CA74 - 48 MESSING AT TABLES CA75.
97 TOTAL MESSING CA74, 81 TOTAL MESSING CA75.
19 HAMMOCKS
CREW'S MESS CA74 CA75
MESSING AT COUNTERS 20 17
MESSING AT TABLES 32 24
TOTAL MESSING 52 41
9 HAMMOCKS.
C.P.O. BERTH
DETACHED VIEW. MASTER AT ARMS OFFICE. B-207-3L. CA-74 AND 75 ONLY.
CA73 thru CA75 Incl.
CA73 thru CA75 Incl.

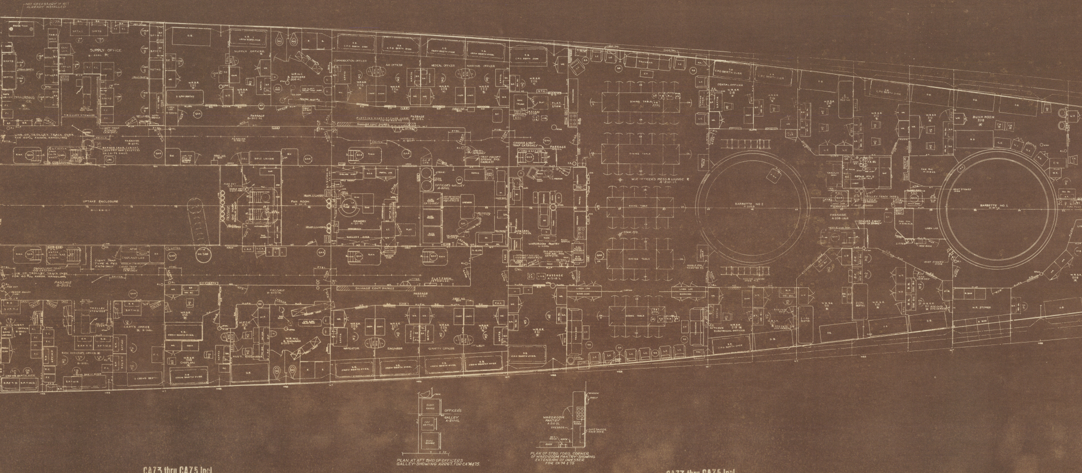
NOT NECESSARY IF NOT ALREADY INSTALLED
SUPPLY OFFICE B-204L
DISBURSING OFFICE B-204L
TROLLEY STOWAGE
SUPPLY OFFICER
W.R.S.R. 232
W.R.S.R. 230
W.R.W.C. & SHOWERS B-206-4L
COMMUNICATION OFFICER
W.R.S.R. 228
AIR OFFICER
MEDICAL OFFICER
MARINE OFFICER
W.R.S.R. 222
W.R.S.R. 220
PASSAGE B-202-2L
LINE OF TROLLEY TRACK OVER FOR 40 MM AMMN. HANDLING
LIGHT TRAP STOWED CA74 ONLY
PASSAGE B-204L
BARBER CHAIR, CABINET LAUNDRY AND LAVATORY ON CA-75 ONLY
RIFLE LOCKER
PLOTTING BOARD STOWED UNDER
DAMAGE CONT. SHORES
PASSAGE A-211L
UPTAKE ENCLOSURE
PASSAGE
GAS MASK REPAIR SHOP
FAN ROOM
ARMORY A-211-8L
OFFICER'S GALLEY A-211-1L
CANVAS LIGHT TRAP CA73 ONLY
PASSAGE A-210L
TEST EQUIPT. SPRINK. SYS. CA74 & 75
PLAT. STOW.
WARDROOM PANTRY A-210-1L
SEE DETACHED VIEW BEL. FOR CA74 & 75
DINING TABLE
DINING TABLE
W.R. OFFICER'S MESS & LOUNGE A-210-1L
DINING TABLE
STAN. P/S
DINING TABLE
TRANSOM
DENTAL OFFICER
W.R.S.R. 218
W.R.S.R. 216
W.R.S.R. 214
2 C.P.O. BERTHS
W.R.S.R. 212
W.R.S.R. 210
BUNK ROOM 208
C.P.O. BERTH OVER
REPAIR STA. II
TROLLEY TRACK OVER
BARBETTE NO. 2 A-208-B
PASSAGE A-208-1ALE
CANVAS LIGHT TRAP CA 75 ONLY
FAN RM.
LINEN LKR.
HOIST STOWED OVER
BARBETTE NO. 1
SHELF FOR TOASTER P/S
LINEN LKR.
BOOKCASE
W.R.S.R. 217
ELECTRICAL OFFICER
W.R.S.R. 215
2 C.P.O. BERTHS
W.R.S.R. 213
W.R.S.R. 211
W.R. STORES
W.R.S.R. 209
LIGHT TRAP TYPE 4. P&S. CA74 ONLY
CANVAS LIGHT TRAP P/S CA73 ONLY
CHAPLAINS LKR.
LINE OF TROLLEY TRACK OVER FOR 40 MM AMMN. HANDLING
PASSAGE B-205L
GUNNERY OFFICE B-205L
EXEC OFFICERS OFFICE B-205L
CREWS BERTH OVER
TROLLEY STOWAGE
CAPT'S OFFICE B-205L
W.R.S.R. 233
W.R.S.R. 235 CHAPLAIN
PASSAGE B-203-3L
W.R.S.R. 231
ASS'T. ENGINEER
W.R.W.C. & SHOWERS B-203-1L
PLATFORM STOWAGE
DAMAGE CONT. SHORES
PASSAGE A-213L
W.R.S.R. 229
NAVIGATOR
W.R.S.R. 227
ENGINEER
W.R.S.R. 225
GUNNERY OFFICER
W.R.S.R. 223
1ST LIEUT
S.B. CREW BERTH OVER
C.P.O. BERTH OVER
ELECT RANGE
OFFICER'S GALLEY A-211-1L
FRY KETTLE
ELEC RANGE
PLAN AT AFT BHD OF OFFICERS GALLEY-SHOWING ARRGT. FOR CA74 & 75.
WINDOW
SHELF
WARDROOM PANTRY A-210-2L
ELEC RANGE
DRESSER
CUP & SAUCER RACK OVER
SEA RAILS
RACK
RACK
PLAN OF STBD. FORD. CORNER OF WARDROOM PANTRY-SHOWING EXTENSION OF DRESSER FOR CA 74 & 75

CA73 thru CA75 Incl.

CA73 thru CA75 Incl.

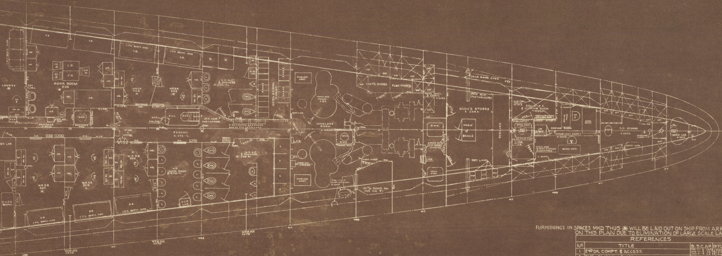
BUNK ROOM 206
PASSAGE
W.R.S.R. 202
W.R.S.R. 205
W.R.S.R. 207
WINDLASS ROOM
CAPT'S STORES
FLAG STORES
JACK ROD (PORTABLE)
BOSN'S STORES A-204A
CANVAS ROOM
S.D. STORES A-201A
40 M/M RADAR RM.
W.T.
WEB

ABBREVIATIONS

A.E.	AIR ESCAPE
A.G.	ARMOR GRATING
AL.J.	ALUMINUM JOINER
A.O.	ACCESS OPENING
A.P.	AFTER PERPENDICULAR
AL.J.F.T.	ALUMINUM JOINER FUME TIGHT
AL.P.	ALUMINUM PILASTER
AL.P.M.	ALUMINUM PILASTER WITHOUT EXPANSION PLATE
AMM. T.	AMMUNITION TRUNK
A.T.D.	AIR TIGHT DOOR
AM. OR AMM.	AMMUNITION
B.	BERTH
B.B.	BULLETIN BOARD
B-1 OR B-2	CREWS LOCKER
B.L.	BLUE LIGHT
B.R.	BOOK RACK
BEL.	BELOW
BHD.	BULKHEAD
BUKT.	BUCKETS
B.&P.	BARE & PAINTED
BOT.	BOTTOM
B.P.C.	BOLTED PLATE COVER.
C.B.	CONNECTION BOX.
℄	CENTER LINE.
CH.	CHAIR
C.H.	COAT HOOKS
CHIFF.	CHIFFONIER
CL. G. LKR.	CLEANING GEAR LOCKER
C.L.	CEILING LIGHT
COAM.	COAMING
C.T.	COFFEE TABLE
CONT.	CONTROLLER OR CONTROL
C.R.	CURTAIN ROD
C.P.O.	CHIEF PETTY OFFICER
C.D.	CHEST OF DRAWERS
D.	DOWN
DWR.	DRAWER
D.B.	DOUBLE BERTH
D.D.	DECK DRAIN
DIR.	DIRECTOR
D.P.F.T.D.	DOUBLE PEDESTAL FLAT TOP DESK
D.P.T.W.D.	DOUBLE PEDESTAL TYPEWRITER DESK
D.T.C.	DOUBLE TOILET CASE
D.O.	DOOR OPENING
D.C.P.	DAMAGE CONT. PATROL
D.S.	DECAMMING SCUTTLE.
D.T.	DINING TABLE.
DET.	DETACHABLE.
DISCON.	DISCONNECTING.
E.B.	ELECTRIC BOX
E.M.	EXPANDED METAL
EXH.	EXHAUST
E.M.D.	EXPANDED METAL DOOR
E.R.	ELECTRIC RELAY
E.SW.	ELECTRIC SWITCH
E.T.	ELECTRIC TRANSFORMER
E.W.H.	ELECTRIC WATER HEATER
F. BX.	FUSE BOX.
F.B.F.P.M.	FUSE BOX FIRING AND PUMP MOTORS.
F.A.B.	FIRST AID BOX
F.B.	FOLDING BERTH
F. CAB.	FILE CABINET
F.H.R.	FIRE HOSE RACK
F.L.	FIXED LIGHT
FR.	FRAME
F.P.	FORWARD PERPENDICULAR
F.T.	FUME TIGHT
F.W.H.	FLUSH WATERTIGHT HATCH
F.W.M.H.	FLUSH WATERTIGHT MANHOLE
F.O.	FUEL OIL
F.E.	FIRE EXTINGUISHER
F.&F.	FIRE & FLUSHING SYSTEM
G.D.	GARBAGE DISPOSAL
G.R.	GRAB ROD
GEN.	GENERATOR
H.R.	HOSE RACK
H. SHF.	HINGED SHELF
H.W.	HINGED WINDOW
I.L.	INCLINED LADDER
IND.	INDICATOR
INS.	INSULATION
I.S.	INSECT SCREEN
I.T.	ILLUMINATION TRANSFORMER.
I.C.	ICE CREAM.
K.L.	KEY LOCKER
L.A.B.T.	LIGHTING AUTO. BUS TRANSFORMER.
LAV. OR L.	LAVATORY
L.B.	LETTER BOX
L.C.C.	LIBERTY CARD CABINET
L.D.B.	LIGHT DISTRIBUTION BOX
L.C.	LOUNGE CHAIR
L.F.D.B.	LIGHT FEEDER DISTRIBUTION BOX
L.R.	LADDER ROUND
LKR.	LOCKER
L.D.P.	LIGHT DISTRIBUTION PANEL
M.	MIRROR
MAG.	MAGAZINE
MACH.	MACHINE
M.H.	MANHOLE
MIX.	MIXING
M.J.	METAL JOINER
M.J.D.	METAL JOINER DOOR
M.P.T.	MESSAGE PASSING TUBE
M.T.	MAIL TRAY
M.J.M.	METAL JOINER WITHOUT EXPANSION PLATE
M.J.P.	METAL JOINER PILASTER
M.J.P.M.	METAL JOINER PILASTER WITHOUT EXPANSION PLATE
N.T.	NON-TIGHT
N.T.D.	NON TIGHT DOOR
N.T.M.H.	NON TIGHT MANHOLE
OFF.	OFFICERS
OPER.	OPERATED
O.T.	OIL TIGHT
P.E.	POWER EQUIPMENT 40 M/M GUNS.
P.F.D.B.	POWER FEEDER DISTRIBUTION BOX.
P.B.	PORTABLE BATTEN
P.D.P.	POWER DISTRIBUTION PANEL
PLAT.	PLATFORM
P.S.	PASSING SCUTTLE
P.&S.	PORT & STARBOARD
P.F.D.P.	POWER FUSE DISTRIBUTION PANEL
P. LKR.	PEACOAT LOCKER
PTBL.	PORTABLE
P.P.	POWER PANEL
P.T.	POWER TRANSFORMER.
P.T.S.	POWER TRANSFORMER SWITCH.
Q.A.E.S.	QUICK ACTING ESCAPE SCUTTLE
Q.A.W.D.	QUICK ACTING WATERTIGHT DOOR
R.B.	RESISTOR BOX
RAD.	RADIATOR
REFRIG.	REFRIGERATOR
RM.	ROOM
R.W.H.	RAISED WATERTIGHT HATCH
R.W.M.H.	RAISED WATERTIGHT MANHOLE
R.S.	READY SERVICE
R.L.	RED LIGHT.
SK.	SINK
SCR.	SCREEN
SEC. BU.	SECRETARY BUREAU
SHF.	SHELF
S.B.	SWITCH BOX
S.	SHOWER
S.P.	STEAM PIPE
S.P.F.T.D.	SINGLE PEDESTAL FLAT TOP DESK
S.P.T.W.D.	SINGLE PEDESTAL TYPEWRITER DESK
S.T.S.	SPECIAL TREATMENT STEEL
STAN.	STANCHION
SGL.	SINGLE
STD.	STANDARD
S.TR.	SAFETY TREAD
S.S.	SMOKE STAND
S.V.	SUPPLY VENT
S.R.	STATEROOM
S.W.	SERVING WINDOW
SW. P.	SWITCH PANEL
S.O.S.	SURVEILLANCE OVEN STAND
ST.	STOOL
S.T.	SOUNDING TUBE
STOW.	STOWAGE
S.L.	SAFE LOCKER
S.T.C.	SINGLE TOILET CASE
STER.	STERILIZER
S.G.B.	SPARE GUN BARREL
S.D.	SUPPLY DEPARTMENT.
T.	TRANSFORMER.
TEL.	TELEPHONE
T.L.P.	TRANSFER LIGHTING PANEL
TR.	TRUNK
TRANS.	TRANSMITTER
T.R.	TOWEL ROD.
U.	URINAL
VENT. OR V.	VENTILATION
V.C.S.	VALVE CONTROL STATION
V.L.	VERTICAL LADDER
V.T.	VOICE TUBE
W.C.	WATER CLOSET
W. MH.	WATERTIGHT MANHOLE
W.R.	WARDROOM
WR.	WARDROBE
W.R.SR.	WARDROOM STATEROOM
W.O.	WARRANT OFFICERS
W.T.	WATERTIGHT
W.W.	WIREWAY
W.TR.	WIRING TRUNK

FURNISHINGS IN SPACES MKD. THUS ✱ WILL BE LAID OUT ON SHIP FROM ARRG'T. AS SHOWN ON THIS PLAN DUE TO ELIMINATION OF LARGE SCALE LAYOUTS.

REFERENCES

Nº	TITLE	B.S.C. Nº	OFFL. Nº	BU. S. Nº
1	2ND DK. COMPT. & ACCESS.	1504-11-5 1504-11-5 1504-11-5	CA73/51601 CA74/51601 CA75/51601	522185 522227 522287
2	2'-3" x 13'-0" WALLBOARD.	N-55-H	3704 AP	CA72-53301-522607
3	LIST OF CHAIRS.	1504-236-67	CA-72 S3	306-176292
4	METAL FURNITURE LIST.	1504-11-758A	3704-AP	3704-AC 3704-AP
5	TYPE OF CURTAIN FITTINGS.	1504-236-66	CA-72 S3	306-177849
6	TRANSOM DK. SOCKET.	N-73-A		CA72-53306-522613
7	STD. FURNISHING OF STATERMS.	1504-11-43	4664	411005
8	OUTFIT FOR S.R. & CABINS.	1504-11-72	CA-72 S3	302-176372
9	CURT. RODS FOR DOOR OPENINGS.	N-151-A	CA-122-S3	306-522581
10	LIST OF SPECIAL ARTICLES.	1504-236-583	4705	411045
11	AMM. HANDLING ARRGT. (FORD)	1504-531-1	CA-72 57802	522498
12	AMM. HANDLING ARRGT. (AFT.)	1504-531-87	CA-72 57802	522499
13	TROLLEY TRACKS FOR HANDLING 40 M/M AMM.	1504-531-73	CA-72 57802	176298

WARDROBE SHELVES FITTED ON CA-73
WARDROBES FITTED ON CA-74-75

CA73 thru CA75 Incl.

CA73 thru CA75 Incl.

THIS PLAN
SUPERSEDES
PLAN 1504-11-16
CA72-50103-522340
UP TO & INCLUDING ALT III

Nº	ALTERATION	BY	CONT. DATE	CONT. APP'D	GOVT. DATE	GOVT. APP'D

1. Q.A.S. ABT. FR. 88 STBD. RELOCATED TO ABT. FR. 84 STBD. TO SUIT REF. 1.
2. COMPT. NOS. ADDED TO SUIT REF. 1 AT REQUEST OF S. OF S.
3. STOWAGE OF ACETYLENE BOTTLES FR. 128 PORT REVISED TO SUIT PLAN 1504-232-177 ALT. IV.
4. STOW. LKR. ADDED IN CANVAS ROOM BET. FRS. 7 & 8 STBD. TO SUIT PLAN 1504-236-110.
5. BOSN'S STORES COMPT. A-202A CHG'D TO S.D. STORES & REVISED TO SUIT PLAN 1504-232-62 ALT XIII.
6. W.R.S.R. 222 ASS'G'D TO MARINE OFFICER. W.R.S.R. 230 ASS'G'D TO SUPPLY OFFICER. W.R.S.R. 231 ASS'G'D TO ASS'T. ENGINEER. AS REQUESTED IN S. OF S. LET. CA72-75/S33(N65-SH) OF AUG 22, '44.
7. GUNNERY OFFICE REVISED AS REQUESTED IN S. OF S. LET. CA72-75, 122-129, 130-138, 135-136, 137-138/S32-(M9216-DH) OF AUG 12, '44 & CONFIRMED BY BUREAU REPRESENTATIVE SEPT. 11, 1944.
8. TROLLEY TRACK INDICATED TO SUIT REF. 1.
9. CASHIERS ENCLOSURE DELETED (CASH REGISTER ADDED TO SHIPS SERVICE STORES TO SUIT S. OF S. LET. CA72/CA122/[illegible]-(N5321-DH) OF SEPT. 13, 1944.
10. MESS SEATS FR. 98 PORT REVISED TO SUIT PL. 1504-236-47.
11. S.D. STORES CHG'D TO BOSN'S STORES & REVISED TO SUIT PL. 1504-232-54.

I	APPROVAL	22-255	19 Sept 44	[illegible]	9/30/44	D.

1. REPAIR STA. V RELOCATED FROM FRS. 86-84½ & TO 3RD DK. & REPAIR STA. IV REVISED TO AGREE WITH DET. PL. & S.O.S. LET. CA72/S1-6(N2890-DA) OF 14 SEPT 1944.
2. PORTION OF CREWS MESS B-106-1L BET. FRS. 85-90 P. OUTBOARD DELETED AND MOTION PICTURE EQUIPMENT STOWAGE, FILM LOCKER AND BATTLE DRESSING STATION NO. I ADDED & BATTLE DRESS. STA. NO. I, FRS. 87-89 PORT DELETED.
3. SEWING MACH. ADDED IN CANVAS ROOM FRS. 5-6 PORT.
4. DOUBLE TOILET CASE ADDED IN S.R. 210.
5. CLEANING GEAR LKR. RELOC. FROM FR. 62 PORT TO FR. 68½ PORT TO CLEAR PIPING.
6. TABLE LEAF LKR. DELETED IN C.P.O. MESS FRS. 131-132 PORT.
7. DAMAGE CONT. PATROL LKRS. ADDED TO AGREE WITH S.O.S. LET. CA72/S88(N973-DA) OF 28 AUG 44.
8. 18" DIA. Q.A.S. INDICATED BET. FRS. 85-86 STBD. TO AGREE WITH ITEM 3 ALT. XVI ON REF. I.
9. SPARE 40MM GUN BARREL STOW. ADDED AT FRS. 11-12 STBD., FR. 15 P & S & FRS. 150-151½ STBD. TO AGREE WITH 1504-331-1 & 87.
10. W.R.S.R. 232 TOILET CASE INTERCHANGED WITH SEC. BUREAU TO AGREE WITH ARRGT. ON CA72.
11. SHELVES IND. IN 1ST LT. & DAM. CONT. OFFICERS OFF. TO SUIT 1504-11-82. TYPE OF BARBER CHAIRS CHGD AS REGULAR TYPE ARE NOW AVAILABLE.
12. CURTAINS ADDED IN WAY OF DOORS TO W.R. MESS FRS. 54 P. & S. & FR. 58 P. & S. AND IN WAY OF DOOR TO S.R. 255 TO SUIT 1504-236-66.
13. CHAPLAINS LKR. ADDED BET. FRS. 73 & 74½ STBD. TO SUIT S.O.S. LET. CA55/CL-97-9 CA72/CA122/CA130/S32(N5868-DA) 5 OCT. 1944.
14. ALL MAJ. F.T. BHDS. ON MAIN BODY OF PLAN MODIFIED TO AGREE WITH ALT. XIII ON REF. I.
15. SHIP SERVICE STORE & SUPPLY LKR. FRS. 33-34 P. ADDED TO AGREE WITH PLAN 1505-236-116.
16. ONE BOOK RACK DELETED IN W.R.S.R. 209.
17. COMPT. NOS. ADDED IN WAY OF TRASH BURNER FRS. 98-102 P. TO AGREE WITH REF. I.
18. DETACHED VIEWS OF S.R.s 211 & 217 DELETED AND ARRGT. INDICATED ON MAIN BODY OF PLAN AS SAME IS NOW APPLICABLE TO CA73 IN ADD. TO CA74 & 75. TO SWITCH CHANGE MAKING S.R. 202 & 204 RADAR ROOMS ON CA73.
19. W.R.S.R. 211 ARRANGED TO SUIT INTERFERENCES ON SHIP.
20. CHEST OF DRAWERS ADDED IN BUNK ROOMS 206 & 208 TO SUIT ITEM 41C S.O.S. LET. CA-72/S8 (7530-T) 24 OCT. 44.
21. SHELFS FOR TOASTERS ADDED OVER SERVING TABLES IN W.R. MESS. & LOUNGE BHD. 60 P/S TO AGREE WITH PLAN 1504-236-19.
22. SHELVES FOR TOASTERS ADDED OVER SERVING TABLE C.P.O. MESS FRS. 129-130 P. TO AGREE WITH PLAN 9411-36.
23. STORAGE OF DAMAGE CONT. SHORES OF FORD SIDE OF BHD. 90 RELOC. TO FRS. 94-95 P. TO AGREE WITH 1504-232-272.
24. CLEAN. GEAR LKRS. BHD. 112 P. & BHD. 120 S. RELOC. TO FORD SIDE OF BHD. 120 P. TO SUIT WORK ON SHIP.
25. W.R.S.R. 231 REVISED TO AGREE WITH SK. 1505-11-1031.
26. S.P.T.W. DESK IN SUPPLY OFFICE AT BHD. 72½ PORT CORR. TO S.P.F.T. DESK.
27. E.M. BHD. FR. 32 STBD. INDICATED TO SUIT REF. I. & DISPLAY CASE ADDED TO SUIT.
28. SHELF ADDED AT DOOR TO SHIPS SERVICE STORE & SHELF IN WAY OF CASH REGISTER DELETED TO SUIT PL. 1504-236-17.
29. SHELF & GARBAGE DISPOSAL CAN FRS. 88-90 PORT DELETED TO SUIT DELETION OF CREWS MESS.

II	APPROVAL	22-31	26 Nov '44	[illegible]	12/13/44	D.

1. SUCTION HOSE AT STBD. SIDE OF BARBETTE NO. I DELETED TO AGREE WITH PLAN 1504-232-143.
2. HOSE RACK INDICATED AT OUTBD. SIDE OF LINEN LKR. FR. 30½ STBD. TO AGREE WITH PL. 1504-236-57.
3. SCALING LADDERS INDICATED OVER AT FRS. 45-48 P/S. TO AGREE WITH PL. 1504-236-57.
4. TOILET CASES IN W.R.S.R.s 211, 217 & 231 REVISED TO AGREE WITH METAL FURN. LIST.
5. CURTAIN IN WAY OF DOOR TO CHAPLAIN'S B.R. 255 DELETED TO AGREE WITH PL. 1504-236-66.
6. COMPT. NO. C-206 E ADDED TO SUMP FRS. 163-164 & PORT TO AGREE WITH REF. I.
7. RINSE WATER TANK IN DISBURSING OFFICE FRS. 78-80 PORT NOTED AS NOT NECESSARY IF NOT ALREADY INSTALLED TO SUIT PL. 1506-18-[illegible] & S.O.S. LET. CA72-75 CLASS/CA122 CLASS/CA130 CLASS/S32/(P3229-DA) OF 15 DEC. 44. FORWARDING BU. SHIPS LET. SECT. 331-336 [illegible] OF 6 DEC. 44.
8. SEWING MACH. FRS. 5-6 PORT MOVED FORD. TO AGREE WITH PL. 1504-232-263.
9. CLEANING GEAR LOCKER INDICATED IN C.P.O. W.R. & W.C. AT BH. 87 PORT TO AGREE WITH PLAN 1504-11-45.
10. HOISTS SHOWN STOWED OVER AT FR. 37 STBD., FR. 38 PORT AND FR. 41½ P. ALSO TROLLEY TRACK OVER INDICATED BET. FRS. 38-43 PORT TO AGREE WITH PLAN 9455/1-2.
11. REPAIR STATION IV, B-206-1L BET. FRS. 80-84½ P. REVISED TO AGREE WITH PLAN 1505-236-39.
12. BUNK ROOM 208 AND LOUNGE BET. FRS. 36-37 PORT REVISED AT REQUEST OF S.O.S.
13. SUPPLY AND DISBURSING OFFICES BET. FRS. 73½-80 P. REVISED TO AGREE WITH PLAN SK. 1504-11-400 AND S.O.S. LET. CA72/S32 (M-460-DA) OF 7 JUNE 44.
14. FIRE EXTINGUISHERS ADDED AT FOLLOWING FRAMES: [illegible]
15. LITTERS REVISED AS FOLLOWS. STOKES TYPE AT FR. 39 PORT AND 127½ STBD. DELETED. WEBER TYPE ADDED AT FRAMES [illegible] AND 136½ S. ARMY TYPE ADDED AT FR. 134½ P.
16. FILE CABINETS IN SUPPLY AND DISBURSING OFFICES BET. FRS. 73½-80 P. AND GUNNERY OFFICE BET. FRS. 78-80 S. REVISED.
17. FIRST AID BOX MOVED FROM AFT TO FORD SIDE OF BHD. 40 STBD SIDE TO CLEAR A.T. DOOR.
18. PLATFORM STOWAGE ADDED AT FRS. 54 P. & S., 68 P. & S., 115 S. AND 150 S.

III	APPROVAL	22 31-17	23 Jan 45	O.B.B.	2/1/45	D.

1. RELOCATE THE D.C.P. CHR. AT FR. 32 P. TO JUST FORWARD OF WEB AT SHELL STBD. FR. 23 IN THE W.R. WASHROOM TO AGREE WITH WORK ON SHIP.
2. FIRE PLUG AT FR. 31¾ P. MOVED AFT. TO FR. 32 TO AGREE WITH 1504-18-F-3.
3. REFERENCES 11-12 AND 13 ADDED.
4. PLAN REVISED TO AGREE WITH REFS. 11 & 12.
5. SPACE FOR BREAD SLICING MACH. INDICATED IN BREAD ROOM BET. FRS. 120-123 S. TO AGREE WITH PLAN 1504-236-14.
6. PLAN REVISED TO AGREE WITH PLANS 1504-20-562, 563 AND 564 (ELEC. EQUIP.) AND ABBREVIATIONS FOR EQUIPMENT ADDED.
7. RECESS AND DOOR ON AMM. HOIST BET. FRS. 56-57 P. REVISED.
8. D.C.P. LOCKER AT FR. 68½ S. MOVED TO FR. 68 S. TO CLEAR ELEC. PANEL.
9. AMM. PASSING SCUTTLE OVER BET. FRS. 112-113 P. & S. ADDED.
10. HEIGHT OF PORT. PLATS BET. FRS. 112-113 P. & S. GIVEN AND MARKED HINGED.
11. HINGED WINDOW AND LOUVER OVER ON FR. 123½ S. REVISED.
12. S.B. PANEL ON BARBETTE AT FR. 132 P. CHANGED TO TRANSFORMERS AND P.P.D.9.
13. FIRE EXTINGUISHER ON BHD. 161 P. RELOCATED AT FR. 165½ S TO CLEAR TRANSFORMER.
14. PASSING SCUTTLE BET. FRS. 163-164 P. RELOCATED TO AGREE WITH PLAN 1504-11-7.
15. PORTABLE METAL STAGE BET. FRS. 163-164 P. RELOCATED TO CLEAR CONTROLS.
16. FUEL OIL OVERFLOW BET. FRS. 102-103 P. RELOCATED.
17. CREWS MESSING ARRGT. CHANGED AS FOLLOWS TO AGREE WITH PLAN 1504-11-41.
    - COUNTER BET. FRS. 93½-95 P. COMPT. NO. B-207-1L P. FROM 4 TO 5 MEN.
    - " " " 100-102 S. " " B-208-1L C " 5 - 4 "
    - " " " 97½-98 S. " " B-108-1L S " 7 - 8 "
    - " " " 103-104½ S. " " B-208-1L S " 2 - 3 "
18. TROLLEY TRACKS P. & S. REVISED TO AGREE WITH PLAN 1504-231-73.
19. SWITCHES AND PORTABLE SECTIONS ADDED.
20. TROLLEY STOWAGE ON 75 S, 75½ P, 76½ S. AND 77½ P. ADDED.
21. PORTABLE SECTION IN TROLLEY TRACK BET. FRS. 37½-41½ P. ADDED.
22. .50 CAL. A.C. AMM. STOWAGE BET. FRS. 140½-151 S. ADDED.
23. TROLLEY TRACK BET. FRS. 139½-157½ S. WITH PORTABLE SECTION AND STOWED HOIST ADDED.
24. NOTE BELOW REF. COLUMN REGARDING WARDROBES REVISED.
25. NOTE ADDED ASSIGNING BARBER CHAIR, CABINET, LAUNDRY AND LAVATORY BET. FRS. 75-77 P. TO CA-73 ONLY.
26. R.W.T. HATCH OVER BET. FRS. 76-78 P. & S. ADDED TO APPLY TO CA-74-75.
27. INCLINED LADDER ON 2ND. DECK BET. FRS. 76-78 P. & S. ADDED TO APPLY TO CA-74-75.
    ITEMS 25-26 AND 27 ADDED TO AGREE WITH SK. 1504-11-1068
28. EXHAUST HOSE FOR I.C.C. PUMPS ADDED BET. FRS. 18-24 P. AND 145-151 P. TO AGREE WITH PLAN 1504-232-145.
29. FIRE EXTINGUISHER AT FR. 76 S. MOVED TO FR. 75½ S. TO CLEAR LIGHT TRAP.

IV	APPROVAL	W.A.W.	[illegible]	[illegible]	3/2/45	D.

1. THAWING BASKETS ADDED IN BUTCHER SHOP BET. FRS. 124½-128 PORT ADDED TO AGREE WITH PLAN 1504-236-12. FOR CA73 ONLY
2. WIREWAY BET. FRS. 97½-98 P. & S. DELETED.
3. NOTE ADDED ASSIGNING ARRGT. OF C.P.O. PANTRY C-202-3L BET. FRS. 150½-155 S. TO CA 73 ONLY.
4. DETACHED VIEW OF C.P.O. PANTRY C-202-3L BET. FRS. 150½-155 S ADDED FOR CA 74 AND 75.
5. SINK ADDED IN DISH WASHING MACH. ROOM B-104-L BET. FRS. 105-108½ STBD ADDED FOR CA-74 AND 75.
6. STOWAGE OF PLOTTING BOARD IN PASSAGE A-305-L BET. FRS. 61-63½ PORT ADDED FOR CA-74 AND 75.
7. CLEANING GEAR LOCKER IN CREWS GALLEY BET. FRS. 134½-135½ STBD MOVED TO PASSAGE BET. FRS. 150½-157 ON CA-74 AND 75.
8. SHELF ADDED ON AFT SIDE OF BHD. 75½ P. TO AGREE WITH PLAN 1504-236-17.
9. FOLLOWING B-3 LOCKERS OMITTED IN CREWS BERTHING C-204-1AL BET. FRS. 161 AND 151½ ON CA 74 AND 75.
   - FR. 164 8'-3" OFF ℄ S. 2 LOCKERS OFF | FR. 150½ 16'-6" OFF ℄ P. 2 LOCKERS OFF
   - 164 15'-4½" " " P. 2 " " | " 150½ 16'-0" " " P. 2 " "
10. MESS BENCHES INDICATED.
11. NOTE ADDED ASSIGNING ARRGT. OF CREWS MESS B-207-3L BET. FRS. 90-97½ P. TO CA 73 AND 75 ONLY. (ALT. CONT. ABV. AT RIGHT)

NO.	ALTERATION.	BY.	CONT. DATE	CONT. APP'D.	GOVT. DATE	GOVT. APP'D.

12. DETACHED VIEW ARRGT. CREWS MESS B-207-3L (PART) BET. FRS. 90-97½ PORT ON CA-74 AND 75 ADDED, TO SUIT WORK ORDER CA74-22-43.
13. C.P.O. BERTHS INDICATED IN W.R.S.R. 201, 203, 204, 205, 207, 220, 221, 226 AND 250.
14. CREW BERTHS INDICATED IN W.R.S.R. 202, 223, 224, 225, 227, 229, 230 AND 238.
15. NOTE ADDED ASSIGNING ARRGT. OF MASTER AT ARMS OFFICE B-207-3L BET. FRS. 90-97½ S. TO CA 73 ONLY.
16. TYPE "A" LKR. IN C.P.O. QUARTERS FR. 139 STBD. NOTED FOR CA73 ONLY & DETACHED VIEW SHOWING ARRGT. OF MASTER AT ARMS OFFICE AT FRS. 90-97 STBD. FOR CA74 & 75 WITH TYPE "A" LKR. ADDED TO SUIT S.O.S.

V	APPROVAL.	W.A.W.	28 Feb 45	O.B.B.	4/30/45	D.

1. ELECT. RANGES AT FORD BHD. OF WARDROOM PANTRY FRS. 53½-54 STBD. NOTED FOR CA73 ONLY & DETACHED VIEW ADDED BEL. SHOWING ARRGT. FOR CA74 & 75 TO AGREE WITH WORK ORDER CA74-22-31.
2. ELECT. RANGE IN OFFICERS GALLEY FRS. 60-61 S. NOTED FOR CA73 ONLY & DETACHED VIEW ADDED BEL. SHOWING ARRGT. FOR CA74 & 75 TO AGREE WITH WORK ORDER CA74-22-46.
3. LIGHT TRAP STOWAGE ADDED AT BHD. 75½ PORT & AT SIDE OF CHAPLAINS LKR. FRS. 72½-74½ STBD. FOR CA74 & 75 TO SUIT WORK ON SHIP.
4. RESCUE EQUIPT. LKR. & FIRE EXT. INDICATED AT AFT SIDE OF BHD. 80 PORT FOR CA74 & 75 TO AGREE WITH WORK ORDER CA74-22-53.
5. BATTLE MESSING GEAR STOWAGE ADDED FOR CA74 & 75 AT BHD. 120 & 115 P/S TO AGREE WITH WORK ORDER CA74-22-51.
6. MEAT RAIL ADDED IN BUTCHER SHOP FRS. 124½-128 PORT FOR CA74 & 75 TO AGREE WITH WORK ORDER CA74-22-47.
7. ALL OXYGEN & ACETELYNE CYLS. NOTED FOR CA73 ONLY & RELOC. TO MAIN DK. FOR CA74 & 75 TO AGREE WITH WORK ORDER CA74-22-46.

6	APPROVAL	22-31	28 May 45	O.B.B.	6/13/45	D.

1. DETACHED VIEW ADDED SHOWING ARRGT. OF VEG. PREP. RM. FRS. 120-124½ PORT FOR CA75 TO AGREE WITH W.O. CA75-22-77.
2. STANCHIONS ADDED AT FR. 52 P/S TO AGREE WITH PLAN 1504-124-22.
3. SWING OF E.M. DOOR AT FR. 14½ STBD. CHGD. FROM AFT & OUTBD. TO FORD & INBD. TO AGREE WITH REF. I.
4. ADDITIONAL WEB FRS. INDICATED AT FRS. 20, 24 & 28 FOR CA75 TO AGREE WITH PL. 1507-124-111.
5. TWO TABLES IN CREWS MESS FRS. 101-104 STBD. NOTED FOR CA73 & 74 & BOOKCASES FITTED IN LIEU OF SAME FOR CA75 W.O. CA75-22-81.
6. CANVAS LIGHT TRAPS INDICATED IN WAY OF HATCHES FOR CA75 ONLY TO AGREE WITH PLANS 1507-177-33 & 1507-177-111.
7. E.M. ENCLOSURE ADDED AT FR. 118 STBD. & SPACE WITHIN ASSIGNED TO S.D. STORES, CA75 ONLY TO AGREE WITH REF. I.
8. BOMB VANE STOWAGE FRS. 149-151½ STBD. NOTED FOR CA73 & 74 & MADE UNASSIGNED FOR CA75 TO AGREE WITH PL. 1504-581-26.
9. MESS COUNTER AT AFT SIDE OF BHD. 105 STBD. SHORTENED TO SEAT 4 & D.C.P. LKR. AT FR. 108½ STBD. FITTED AT END OF COUNTER FOR CA75 TO SUIT WORK ON SHIP.
10. RESCUE EQUIPT. LKR. & FIRE EXT. SHOWN AT AFT SIDE OF BHD. 80 PORT RELOC. TO FORD. SIDE OF BHD. 80 STBD. TO SUIT WORK ON SHIP.
11. LKR. FOR SPRINK. SYS. TEST EQUIPT. ADDED AT FR. 58-59 PORT TO SUIT WORK ON SHIP & PL. 1504-232-159.
12. COMPLEMENT OF CREWS MESS B-209-L BET. FRS. 102-117 S. REVISED FOR CA75 TO SUIT WORK ON SHIP.
12. a. OXYGEN & ACET. BOTTLE STOWAGE CORRECTED TO AGREE WITH PL. 1504-232-177
13. CREWS MESSING SPACE FRS. 92-97½ STBD. REARRANGED FOR CA75 TO ALLOW FOR THE INSTALLATION OF GUNNERY TRAINER EQUIPT. TO AGREE WITH PL. 1507-232-306

7	APPROVAL	22-31	23 Aug 45	[illegible]	10/1/45	D.

CA68-75/S1-3
CA122 cl/S1-3
7160546/48

CA73 thru CA75 Incl.

1505-1507	CA-73, 74-75	BETH. STEEL QUINCY
HULL NO.	SHIP NO.	CONTRACTOR

CORRECTED PLAN

BETHLEHEM STEEL CO.
SHIPBUILDING DIVISION
QUINCY YARD, QUINCY, MASS.
HULL DEPARTMENT

SCALE 1/4" = 1 FT.
DRAWN J.R.W. VA-80
TRACED
CHECKED 32-225 C.W.C.

DATE 30-AUG-44
EXAMINED G.E.B.
APPROVED
APPROVED

JOB NO. PLAN NO. 1505-11-16

CA73/S11-6

APPROVED .... DATE ....
LETTER NO. ....
G.W. Bailey
SUPERVISOR OF SHIPBUILDING U.S.N. QUINCY, MASS.
BY DIRECTION

SECOND DECK
GENERAL ARRANGEMENT

BUREAU OF SHIPS PLAN NUMBER

CA73	S0103	522635	7

AUG -6 1951

CA73 thru CA75 Incl.

8" GUN-13000 T-CRUISERS

522635

NOV 17 1947

CA 73,74&75

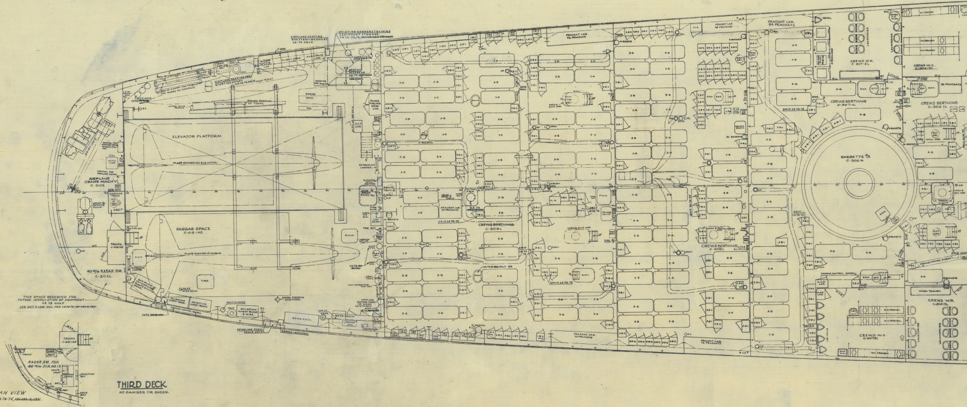
ELEVATOR PLATFORM
PLANE STOWED ON ELEVATOR
HANGAR SPACE
C-418-1AE
PLANE STOWED IN HANGAR
AIRPLANE CRANE MACH'Y
C-310E
HOIST UNIT
HOIST & ROTATE PUMP
GASOLINE TRUNK
C-421T
TRUNK
C-418-1AE
40 M/M RADAR RM.
C-311 CL
GAS PUMP & COMPRESSOR FOR F'CONING GEAR
AVIATION CHEST RACK
AVIATION CHEST RACK
DAMAGE CONTROL SHORES
CA73, ~~130 & 136~~
VALVE OPER GEAR
F.M.R.
THIS SPACE RESERVED FOR
FUTURE INSTALLATION OF EQUIPMENT
CA 73 ONLY
SEE DET. VIEW BEL. FOR CA74-75, ~~131-133 & 135~~
AIRPLANE HEATING
AND STARTING OUTLET
CA-73 ONLY.
AVIATION GUNNERS TRAINING
EQUIPMENT STOWAGE.
ON CA-74,75
AIRPLANE HEATING AND STARTING OUTLET.
CA-74-75 ONLY.
MAIN FLOAT
STOWED POSITION OF TRUCK
OUTER WING PANELS
FLIGHT GEAR LKR.
PARACHUTE LKR.
ENGINE COWL
PLANE FUELING GEAR LKR.
EXTENSION LADDER
ELEVATOR HATCH CONTROL
FIRE PLUG
FIRST AID BOX
FIRE EXT.
CREWS BERTHING
C-305L
CREWS BERTHING
C-308L
PEACOAT LKR.
76 PEACOATS
PEACOAT LKR.
84 PEACOATS
OMIT CA 74-75
CREWS BERTHING
C-307-1L
CREWS W.R.
C-307-2L
LAVATORIES
4 SHOWERS
URINAL
CREWS W.C.
C-304-2L
W.C. TROUGH
CREWS BERTHING
C-304-1L
BARBETTE #3
C-306 B
TRUNK
C-411T
HATCH & Q.A.S. OPER
DAMAGE CONTROL SHORES
WASH TROUGH
CREWS W.R.
C-304-3L
CREWS W.C.
C-307-3L
URINALS
LAVATORIES
RADAR RM. FOR
40 M/M DIR. NO. 13
TRUNK
C-410-1AE
TRANS.
CONT. UNIT
JUNCTION BOX
FUSE BOX

PLAN VIEW

FOR CA 74-75, ~~131-133 & 135~~

THIRD DECK

NO CAMBER OR SHEER

CA 73, 74, & 75

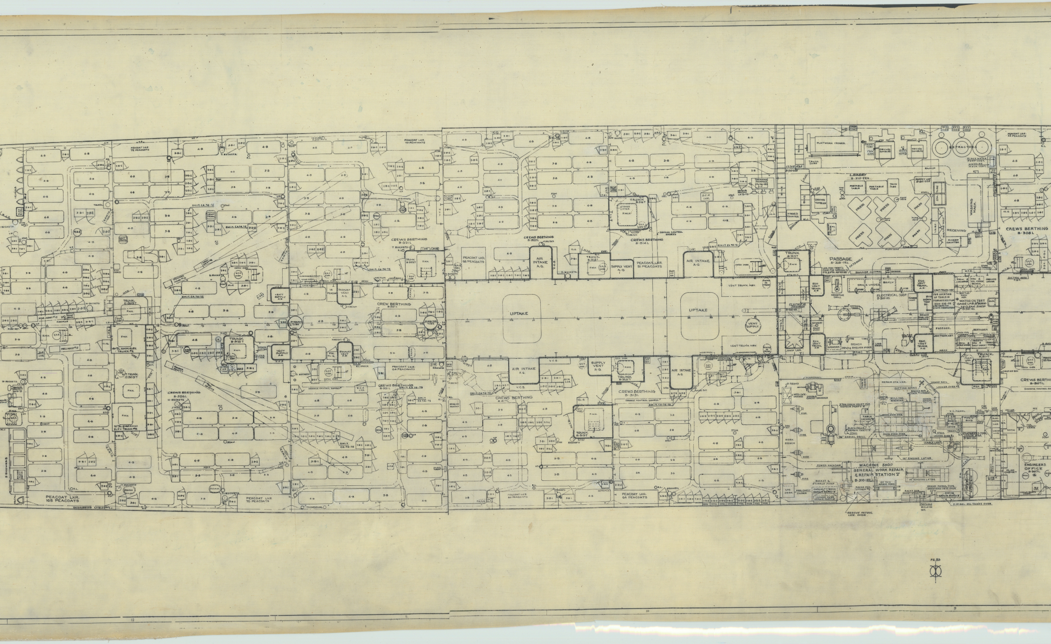
PEACOAT LKR. 72 PEACOATS
PEACOAT LKR. 70 PEACOATS
CREWS BERTHING B-321L
7 BUCKETS
TRUNK B-322T
OMIT CA-74-75
TRUNK C-302T
VENT SUPPLY A-G
EXHAUST VENT A-G
CREW BERTHING B-321L
TRUNK B-323T
40 M/M AMM. ELEV. TRUNK #2
W.T. TRUNK C-303T
20 M/M & 40 M/M AMM. ELEV. TRUNK #3
PEACOAT LKR. 64 PEACOATS
CREWS BERTHING B-326L
11-BUCKETS
CREWS BERTHING B-321L
PEACOAT LKR. 105 PEACOATS
PEACOAT LKR. 70 PEACOATS
5 SHOWERS
DEGAUSSING CABLE
PEACOAT LKR. 68 PEACOATS
AIR INTAKE A.G.
CREWS BERTHING B-320L
TRUNK B-315T
SUPPLY VENT A-G
PEACOAT LKR. 51 PEACOATS
TRUNK B-316T
STOKES LITTER
CREWS BERTHING B-314L
DAMAGE CONTROL SHORES
AIR INTAKE A-G
UPTAKE
UPTAKE
VENT TRUNK ABV.
VENT SUPPLY
AIR INTAKE A.G.
SUPPLY VENT A-G
TRUNK B-315T
AIR INTAKE A-G
CREWS BERTHING B-317L
CREWS BERTHING B-313L
TRUNK B-313T
PEACOAT LKR. 60 PEACOATS
PEACOAT LKR. 64 PEACOATS
FLATWORK IRONER
DRYING TUMBLER
EXTRACTORS
TRUCK TUBS
ISSUE RM. B-310-2EA
LAUNDRY B-310-2EA
PORTABLE TABLE
PORTABLE TABLE
SUPPLY LKR B-310-2EA
PRESS
PRESS
PRESS
PRESS
PRESS
PRESS
WASHING MACH.
RINSE WATER PUMP CONT.
WASHING MACH. CONT.
RECEIVING
HINGED COUNTER
PEACOAT LKR. 55 PEACOATS
CREWS BERTHING B-308L
TRUNK B-312T
PASSAGE B-310-1EL
DAMAGE CONTROL SHORES
EXH. VENT TRUNK A-G
SENSITIVE DRILL
DRWS. UNDER
BENCH
ELECTRICAL SHOP B-310-1EL
ELECTRICAL STOWAGE B-310-1EL
WATER OIL TEST GAGE LAB. & BURNER CLEAN SHOP B-310-1EL
PASSAGE
BENCH DRWS & SHELVES UNDER
GRINDER
LOG DESK
LAMP LKR.
TRUNK B-311-T
CREWS BERTHING B-307L
DAMAGE CONTROL
GUARDRAIL
REPAIR STA. LKR.
CUTTING OUTFIT
LOCKER OVER #2
DOUBLE EMERY GRINDER
MILLING MACHINE
CHAIN HOISTS
3 TON CHAIN HOIST FOR REPAIR PARTY V
TABLE LOCKER #2
BLOCK FALLS REPAIR PARTY V
36" RADIAL DRILL
V.C. PANEL
BENCH LATHE
ENGINEERS TOOL ISSUE RM. B-310-1EL
LOCKER OVER #1
TABLE LKR #1
WORK BENCH
VISE
14" ENGINE LATHE
POWER HACKSAW
MACHINE SHOP GENERAL WORK REPAIR & REPAIR STATION V B-310-1EL
14" ENGINE LATHE
25 TON ARBOR PRESS
BUCKET & STIRRUP PUMP
TOOL CHEST UNDER
CASUALTY DESK REPAIR PARTY V
LOCKER OVER REPAIR PARTY V
RACKS FOR ATTACH #2
RESCUE PATROL LKR. OVER
RESCUE PATROL TYPE BREATHING SETS OVER
RACKS REPAIR PARTY V
PORTABLE WELDING SET
2-10 GAL. OIL TANKS OVER
PLAN CABINET
ENGINEERS OFFICE B-307L
FR. 83
12
11
10
9

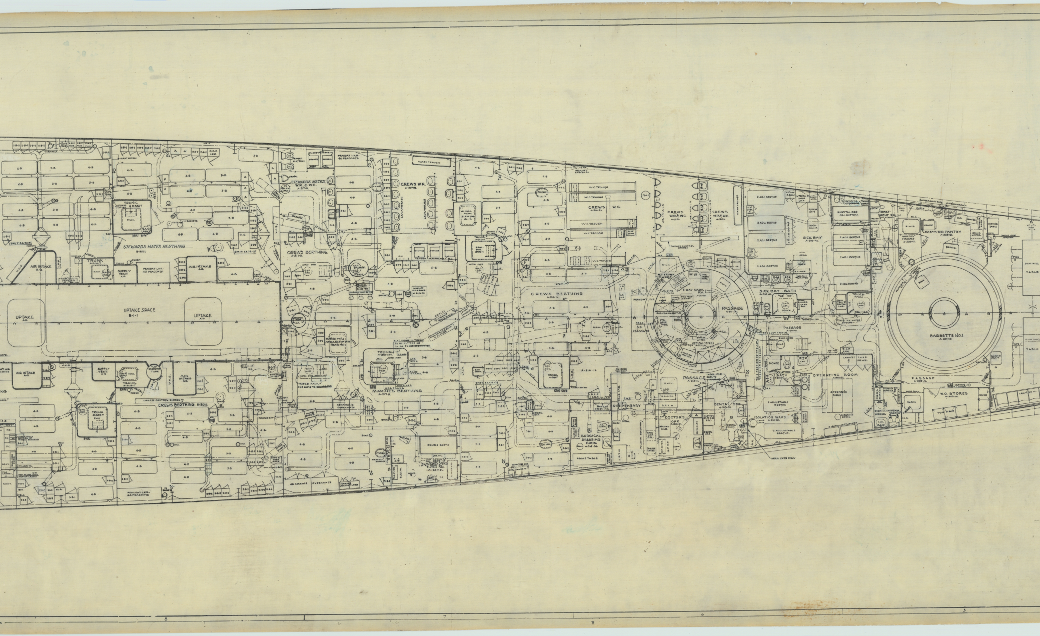
STEWARDS MATES W.R. & W.C.
STEWARDS MATES BERTHING
TRUNK
AIR INTAKE
SUPPLY VENT
PEACOAT LKR. 43 PEACOATS
PEACOAT LKR. 40 PEACOATS
UPTAKE
UPTAKE SPACE B-1-1
UPTAKE
CREWS W.R.
LAVATORIES
CREWS BERTHING
CREWS W.C.
W.C. TROUGH
CREWS BERTHING
CREWS W.R. & W.C.
X-RAY DARK RM.
PASSAGE
2 ADJ. BERTHS
SICK BAY
SICK BAY BATH
PASSAGE
HOSPITAL BED
W.O. PANTRY
BARBETTE NO.1
DINING TABLE
DINING TABLE
AIR INTAKE
SUPPLY VENT
DIRECTOR TUBE
CREWS BERTHING B-301-L
DAMAGE CONTROL SHORES
TRUNK
MARINES BERTHING
RIFLE RACK
48 MARINE OVERCOATS
MARINE OVERCOATS
DOUBLE BERTH
1ST SERGT. OF MARINES OFFICE & STORE RM.
SURGICAL DRESSING ROOM
DISPENSARY
DOCTOR'S OFF.
DENTAL OFF.
PASSAGE
ISOLATION WARD
ISOLATION BATH
OPERATING ROOM
OPERATING TABLE
2 ADJUSTABLE BERTHS
STERILIZING ROOM
PASSAGE
W.O. STORES
INSUL. CATS ONLY
PEACOAT LKR. 60 PEACOATS
4-B
3-B
8
7
6
5

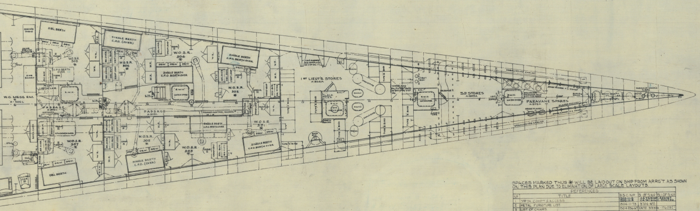
DBL BERTH
SINGLE BERTH C.P.O. (OVER)
SINGLE BERTH C.P.O. BERTH OVER
W.O.S.R. 308
W.O.S.R. 306
W.O.S.R. 304
W.O.S.R. 302
W.O.S.R. 307
W.O.S.R. 305
W.O.S.R. 303
W.O.S.R. 301
W.O. MESS RM. A-306L
PASSAGE A-306L
PASSAGE A-305L
LINEN LKR.
R.W.H.
W.R.
SERVING TABLE
SIDE BOARD
BOOK CASE
1st LIEUT'S. STORES A-304A
S.D. STORES A-303A
PARAVANE SPARES A-302A
VOID A-301A
TYPE "A" BINS
DEGAUSSING CABLES
SPARE PLANES

THIRD DECK

NO CAMBER OR SHEER.

SPACES MARKED THUS ✳ WILL BE LAID OUT ON SHIP FROM ARRG'T. AS SHOWN ON THIS PLAN DUE TO ELIMINATION OF LARGE SCALE LAYOUTS.

REFERENCES				
Nº	TITLE	B.S.C. Nº	B. OF S. Nº	BU. OF S. Nº
1	3RD DK. COMPT. & ACCESS	1505-11-5 1506-11-5	CA 73/S1601 CA 74/S1601	526167 526226
2	METAL FURNITURE LIST	1504-11-73	3704-AF2	
3	LIST OF CHAIRS	1504-236-67	CA72-S3306	176282
4	TYPE OF CURTAIN FITTINGS	1504-236-68	CA72-S3306	177849
5	STD. FURNISHING OF STATE ROOMS	1504-11-43	4094	411005
6	OUTFIT FOR S.R. & CABINS	1504-11-72	CA72-S3302	174372
7	CURTAIN RODS FOR DOOR OPENINGS	N-151-A	CA172-S3306	522581
8	3RD. DK. COMPT. & ACCESS	1507-11-5	CA 75/S1601	526286
9				

WARD ROBES FITTED ON CA-74-75, ~~130-133, 135-136~~

WARDROBE SHELVES FITTED ON CA-73.

ABBREVIATIONS

ABV	ABOVE
A.P.	AFTER PERPENDICULAR
A.E.	AIR ESCAPE
A.G.	ARMOR GRATING
ADJ.	ADJUSTABLE
A.O.	ACCESS OPENING
ARM.	ARMOR
ACCTMT.	ACCOUTREMENT
ACET.	ACETELENE.
AMM.	AMMUNITION.
AUTO.	AUTOMATIC.
AUX.	AUXILIARY.
B.R.	BOOKRACK
BAL.	BALANCED
B.	BERTH
BD.	BOARD.
BEL.	BELOW.
BPC.	BOLTED PLATE COVER.
CAB.	CABINET
C.L.	CEILING LIGHT
℄	CENTER LINE
C.P.O.	CHIEF PETTY OFFICER
CHIF.	CHIFFONIER
Z-B-Z.	CLOTHES LOCKERS
CL. G.	CLEANING GEAR
CH.	COAT & HAT HOOKS
CURT.	CURTAIN
CR.	CURTAIN ROD
CYL.	CYLINDER
C.B.	CONNECTION BOX.
CONT.	CONTROL.
DN.	DOWN.
DK.	DECK
D.P.	DISTRIBUTION PANEL
DR.	DRAIN
DBL.	DOUBLE
D.T.C.	DOUBLE TOILET CASE
DRW.	DRAWER
D.C.P.	DAMAGE CONTROL PATROL.
DRESS.	DRESSING.
ELEC.	ELECTRIC.
EQUIP.	EQUIPMENT
E.M.	EXPANDED METAL
EXH.	EXHAUST
EXT.	EXTINGUISHER
EXT.	EXTRACTOR.
ELEV.	ELEVATOR.
F.E.	FIRE EXTINGUISHER.
FLUSH.	FLUSHING.
F.	FLUSH
F.W.M.H.	FLUSHWATER TIGHT MANHOLE
F.P.	FORWARD PERPENDICULAR
FDN.	FOUNDATION
F.W.	FRESHWATER
F.O.	FUEL OIL
F.T.	FUME TIGHT
F.B.M.H.	FLUSH BOLTED MANHOLE
FOUNT.	FOUNTAIN.
F. BX.	FUSE BOX.
F.O.O.G.	FUEL OIL OVERFLOW GAUGE.
GAL.	GALLON
H.W.	HOT WATER.
H.&C.	HOT AND COLD.
INS.	INSULATION
INSTR.	INSTRUMENT.
I.T.	ILLUMINATION TRANSFORMER.
L.R.	LADDER ROUND
LAV.	LAVATORY
LKR.	LOCKER
L.D.P.	LIGHT DISTRIBUTION PANEL
L.F.D.B.	LIGHT FEEDER DISTRIBUTION BOX
L.A.B.T.	LIGHTING AUTO. BUS TRANSFORMER.
LOADG.	LOADING.
MACH.	MACHINE
M.H.	MANHOLE
M.J.M.	METAL JOINER WITHOUT DEFLECTION PLATE
M.J.P.M.	METAL JOINER PILASTER WITHOUT DEFLECTION PLATE
M.J.	METAL JOINER
M.J.D.	METAL JOINER DOORS
M/M	MILLIMETER
MOD.	MODIFIED
N.T.	NON TIGHT
N.T.D.	NON-TIGHT DOOR
OPER.	OPERATING
O.G.	OPERATING GEAR
PTBL.	PORTABLE.
PROJ.	PROJECTILE
PLT.	PLATE
PWDR.	POWDER
P.E.	POWER EQUIPMENT.
P.F.D.B.	POWER FEEDER DISTRIBUTION BOX.
P.T.	POWER TRANSFORMER.
P.T.S.	POWER TRANSFORMER SWITCH.
QAWD.	QUICK ACTING WATERTIGHT DOOR
Q.A.S.	QUICK ACTING ESCAPE SCUTTLE
RECT.	RECTIFIER.
R.B.	RESISTER BOX.
R.W.M.H.	RAISED WATERTIGHT MANHOLE
R.W.H.	RAISED WATERTIGHT HATCH
REFRIG.	REFRIGERATOR
REP.	REPAIR
R.L.	REDLIGHT
S.TR.	SAFETY TREAD.
SUPP.	SUPPLY.
SEC. BUR.	SECRETARY BUREAU
SHF.	SHELF
S.T.C.	SINGLE TOILET CASE
S.P.F.T.	SINGLE PEDESTAL FLAT TOP
S.T.	SOUNDING TUBE
S.R.	STATEROOM
SYS.	SYSTEM
S.D.	SUPPLY DEPARTMENT.
S.P.T.W.	SPECIAL PEDISTAL TYPE WRITER DESK.
S.T.S.	SPECIAL TREATMENT STEEL
STAN.	STANCHION
STOW.	STOWAGE
T.	TRANSFORMER.
T.C.	TOILET CASE.
T.H.	TOILET PAPER HOLDER
T.R.	TOWEL RACK
T.W.	TYPEWRITER
TRANS.	TRANSFORMER
U.	URINAL.
V.P.	VENT PIPE
VENT.	VENTILATION
V.L.	VERTICAL LADDER
V.C.S.	VALVE CONTROL STATION
VOLT.	VOLTAGE.
W.R.	WARDROOM
W.O.	WARRANT OFFICERS
W.C.	WATER CLOSET
WR.	WARDROBE
W.O.S.R.	WARRANT OFFICERS STATEROOM.
WIRG.	WIRING.

CA68-75 / S1-3
CA122 cl / S1-3
7160546/48

~~THIS PLAN APPLICABLE TO~~
~~CA 72-75~~
~~DISREGARD ALL REFERENCES TO OTHER SHIPS~~

	~~CA 135-136~~	~~PHILA NAVY YARD~~
	~~CA 130-133~~	~~N.Y. SHIPBUILDING CORP.~~
1505-1507	CA-73-75	BETH. FORE RIVER YARD
HULL NO.	SHIP NO.	CONTRACTOR

CORRECTED PLAN

BETHLEHEM STEEL CO.
SHIPBUILDING DIVISION
QUINCY YARD QUINCY, MASS.
HULL DEPARTMENT

SCALE 1/4"=1'-0" DATE 24 JAN-45
DRAWN UA 147 EXAMINED Capt.
TRACED APPROVED
CHECKED JH 124 APPROVED WB

PLAN Nº 1505-11-15

CA73/S11-6

CORRECTED PLAN

APPROVED DATE Jan 26 '45
LETTER NO.
G.W. Bailey
SUPERVISOR OF SHIPBUILDING USN QUINCY, MASS.
BY DIRECTION

SUPERSEDES
1504-11-15
BU. SHIPS NO. CA72-S0103-522393
UP TO AND INCLUDING
ALT. IV

3RD DECK GENERAL ARRANGEMENT

BUREAU OF SHIPS PLAN NUMBER			ALT. NO.
CA73	S0103	522901	

CA 73-75

CA73-75

NET AREA =

NR	ALTERATION	BY

1. TITLE OF MESS ATTENDANTS BERTHING B-30 CHGD. TO STEWARDS MATES AT REQUEST OF S.C.
2. ELECTRICAL EQUIPMENT ADDED IN TRUNK AND ASSIGNMENT TO SHIPS ADDED TO A
3. PLAN REVISED TO AGREE WITH PLANS 1504-20-599-360 AND 361 (ELEC. EQUIP. ON 3RD DECK) AND ABBREVIATIONS COVERING EQUIPMENT ADDED.
4. FIRE EXTINGUISHER AT FR. 118¾ P. MOVED TO FR. 118½ S. TO CLEAR LIGHT FEEDER DISTRIBUTION BOX.
5. FIRST AID BOX MOVED FROM FR. 113 S. TO OUTB'D SIDE OF STANCHION ON FR. 115 S.
6. EQUIPMENT IN HANGAR REVISED TO AGREE WITH PLAN. 1505-232-61
7. AIRPLANE HEATING AND STARTING OUTLETS AT FR. 151½ S. ASSIGNED TO CA-73-75, FR. 154 P. TO CA-73 ONLY AND FR. 157 P. TO CA-74 AND 75
8. HINGED BERTH BET. FRS. 152-153½ S. DELETED AND SHELF OVER WITH ELECTRIC EQUIPMENT ADDED.
9. VENT. AT FR. 154½ S. RELOCATED AT FR. 154½ S.
10. AVIATION CHEST RACK BET. FRS. 155-156 S. DELETED AND BOMB RACK SUBSTITUTED.
11. RUDDER INDICATOR, CHAIN HOIST AND DEFUELING PUMP BETWEEN FRAMES 156-157 S. ADDED.
12. AVIATION RACKS BET. FRS. 157-158 S. MARKED 2 HIGH.
13. CO2 CYLINDER AT FRAME 158¾ S. ADDED.
14. F.W. HATCH ON FRAME 159 S. RELOCATED ON FR. 159½ S.
15. VALVE OPERATING GEAR AT FR. 160¾ S. ADDED.
16. BOMB SLING RACK AT FR. 157 P. DELETED.
17. NOTE ASSIGNING HINGED BERTHS BET. FRS. 152-153¾ PORT TO CA-73, 130 AND 136 ONLY.
18. AVIATION GUNNERS TRAINING EQUIPMENT STOWAGE BET. FRS. 152½-154 P. ADDED AND ASSIGNMENT TO CA-74, 75, 131, 139, 133 AND 135 GIVEN.
19. TROLLEY TRACK BET. FRS. 42 S AND 45 P. REVISED AND PORTABLE SECTION AND EXTENT SHOWN.
20. WIRING TUBES AT FRS. 77½ P. & S. AND 97½ P. & S. DELETED AND 2-8-2 LOCKERS 78¾ P. & S. MOVED FORD.
21. BUCKET STOWAGE REVISED AS FOLLOWS.
    7- BUCKETS ON FR. 112 S. ADDED.
    14 " " " 112½ P. "
    10 " " " 131 P. "
    7 " " WEB FR. 115 P. ADDED.
    7 " " " " 115 S. "
    8 " " INBD STAN. FR. 115 P. ADDED.
    11 " " OUTBD " " 115 P. DELETED.
22. BERTH STOWAGE REVISED AS FOLLOWS.
    CREWS BERTHS ON FR. 60 P. ABT. 6'-6" OFF ℄ CHANGED FROM 4 TO 3.
    " " " " 113 P. " 14'-3" " " " " 4 " 3.
    " " " " 110 S. " 19'-6" " " " " 3 " 4.
23. FOLLOWING LOCKERS OMITTED ON CA.74-75 AND SO MARKED ON PLAN.

4, 2-8-2 LOCKERS BET. FRS. 54-55 S.	1, 2-8-2 LOCKERS BET. FRS. 113-114 P.
6, " " " " " 55-56½ S.	2, " " " " 116-117 P.
2, " " " " " 66-67 P.	2, " " " " 117-118 P.
2, " " " " " 77-78 P.	4, " " " " 126-127 P.
2, " " " " " 91-92 P.	3, 3-8-1 " " " 124-125 P.
3, 3-8-1 " " " 91-92 P.	1, 2-8-2 " " " 131-133 P.
4, 2-8-2 " " " 94-95 S.	2, " " " " 132-133 S.
4, " " " " " 102-103 S.	8, " " " " 137-138 S.
4, " " " " " 108-109 P.	6, 3-8-1 " " " 142-143 S.
2, " " " " " 106-107 S.	9, " " " " 144-145 S.
8, " " " " " 107-108 S.	4, 2-8-2 " " " 170-145 S.
2, " " " " " 109-110 S.	2, " " " " 147-148 S.

24. LOCKER STOWAGE REVISED AS FOLLOWS.
    2-8-2 LOCKERS ON FR. 56¾ P. ADDED.
    " " " " " 60½ S. "
    " " " " " 68½ S. " ABT. 24'-0" OFF ℄
    " " " " " 68½ S. " " 26'-6" " "
    " " " " " 106 S. "
    " " " " " 112½ S. "
    " " " " " 141½ S. "
    " " " " " 105½ S. MOVED INBD.
    " " " " " 61½ S. DELETED.
    " " " " " 66 S. "
    " " " " " 141½ P. "
    " " " " " 47½ S. CHANGED TO 1-8-2 LOCKERS.
    " " " " " 145½ S. " " " " "
    " " " " " 71 S. " " 3-8-1 "
    3-8-1 " " " 76½ S. ADDED.
    " " " " " 102 S. " MOVED OUTB'D.
    " " " " " 50 P. CHANGED TO 2-8-2 LOCKERS.
    " " " " " 71 S. " " " "

ITEMS 21-22-23 AND 24 TO AGREE WITH PLANS 1504-11-40, 50, 51 AND 56 ALSO 1505-11-52 AND 53.

1.	APPROVAL	W.B.M.	22/96 40	R.B.	4/14/45	D.

1. INSULATION IN DENTAL OFFICE FRS. 44-46 STB'D NOTED FOR CA74, 75, 130-133 & 135 TO AGREE WITH PL. 1504-178-4.
2. MANHOLES AT FR. 147 P & S NOTED FOR CA73 & 136 ONLY TO AGREE WITH ALT. 23 ITEM 2 ON REF. I.

2.	APPROVAL	22/96	28 APR 45	O.V.B.	5/2/45	D.

1. STAN. ADDED FR. 52 P. TO AGREE WITH REF. I
2. RIFLE RACKS ADDED FRS. 63-64½ S TO AGREE WITH 11-40.
3. IN MACH. SHOP, GENERAL REPAIR & REPAIR STA. "F" A PRESS MOVED INBD TO AGREE WITH PL. 1505-41-23.
4. DET. VIEW OF TRUNK & RADAR RM. FRS. 163-166 S A FOR CA 74-75, 131-133, 135 AND NOTE FOR FUTURE INSTALLATION MODIFIED TO A WITH REF. #1

3	APPROVAL	22/388	19 JUL 45	O	1/45	D.

1. SCUTTLE ADDED IN HATCH FRS. 147-148 FOR CA13 NLY TO AGREE WITH REF. I.

4	APPROVAL GS	22-31	13 SEP 45	O	27/45	D.

1. OXYGEN, ACET. & FIRE EXT. STOWAGES REVISED TO WITH PLANS 1504-232-177 & 1504-235-2.
2. LKR. FOR TEST EQUIPT. FOR SPRINKLING SYSTEM & BLE AIR TEST SET FR. 88 PORT NOTED FOR CA73 ONL HE HAS BEEN RELOC. ON 2ND DK.
3. RESCUE PATROL & MED. LKR. ADDED IN MACH. SHO WORK REPAIR FRS. 80-90 STBD. TO AGREE WITH PL. 15 ALT. 25

5	APPROVAL GS	22-31	5 OCT 45 WB		45	D.

QUINCY YARD PRINTS

8" GUN-13000 T-CRUISERS

CA-522901

OFFICE
SUPERVISOR OF SHIPBUILDING
FOR U. S. NAVY
BETHLEHEM STEEL COMPANY
(SHIPBUILDING DIVISION)
QUINCY, MASS.
RECEIVED | RETURNED
MAR 28 1945 | JAN 26 1945
APR 26 1945 | APR 10 1945
JUN 30 1945 | APR 14 1945
SEP 18 1945 | MAY 2 1945
OCT 9 1945 | JUL 12 1945
SEP 24 1945
OCT 22 1945
NOV 17 1947